 



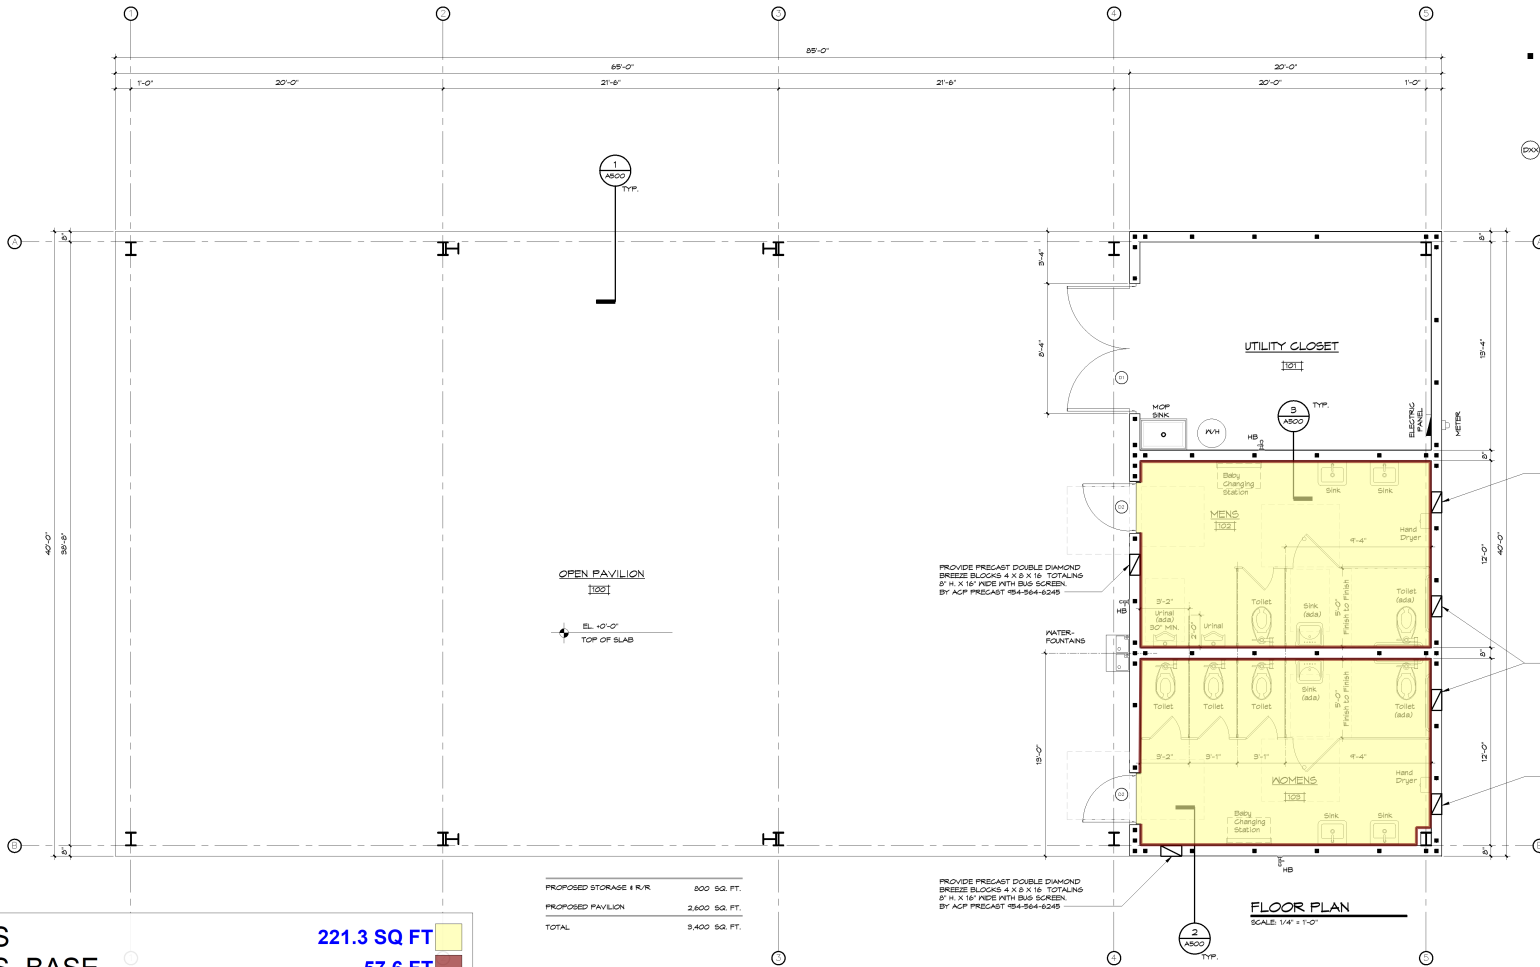


LEGEND

-  MASONRY WALL:  
- 8" EXTERIOR CONCRETE BLOCK WALL FOR REINFORCING SEE STRUCTURAL.
-  MASONRY WALL:  
- 8" OR 10" CONCRETE BLOCK WALL REINFORCED BY #3 @ VERTICAL REBAR @ 4'-0" O.C. MAX.  
- 5/8" GYPSUM BOARD AND A&Z VAPOR SHIELD REFLECTIVE INSULATION FASTENED TO GALVANIZED METAL FURNISH STRIP @ 16" O.C.
-  INDICATES (1) NO. 5 DIA. VERTICAL STEEL ROD REINFORCING FROM FOOTING TO TOP BOND BEAM IN 5,000 PSI GRAVEL GROUT FILLED BLOCK CELLS. PROVIDE #10L EMBEDMENT AND STANDARD HOOK TOP AND BOTTOM AND 30" MINIMUM LAP / SPLICES.
-  DOOR SYMBOL




PROPOSED STORAGE # R/R	800 SQ. FT.
PROPOSED PAVILION	2,600 SQ. FT.
TOTAL	3,400 SQ. FT.

 102 MENS	221.3 SQ FT
 102 MENS BASE	57.6 FT
 103 WOMENS TOILET	220.5 SQ FT
 103 WOMENS TOILET BASE	57.6 FT

FLOOR PLAN  
 SCALE: 1/4" = 1'-0"

- LEGEND**
- MASONRY WALL:  
- 8" EXTERIOR CONCRETE BLOCK WALL FOR REINFORCING SEE STRUCTURAL.
  - MASONRY WALL:  
- 8" OR 10" CONCRETE BLOCK WALL REINFORCED BY #5 @ VERTICAL REBAR @ 4'-0" O.C. MAX.  
- 5/8" GYPSUM BOARD AND A&A VAPOR SHIELD REFLECTIVE INSULATION FASTENED TO GALVANIZED METAL FURNISH STRIP @ 16" O.C.
  - INDICATES (1) NO. 5 DIA. VERTICAL STEEL ROD REINFORCING FROM FOOTING TO TOP BOND BEAM IN 5,000 PSI FEA GRAVEL GROUT FILLED BLOCK CELLS. PROVIDE #10L EMBEDMENT AND STANDARD HOOK TOP AND BOTTOM AND 30" MINIMUM LAP / SPLICES.
  - DOOR SYMBOL

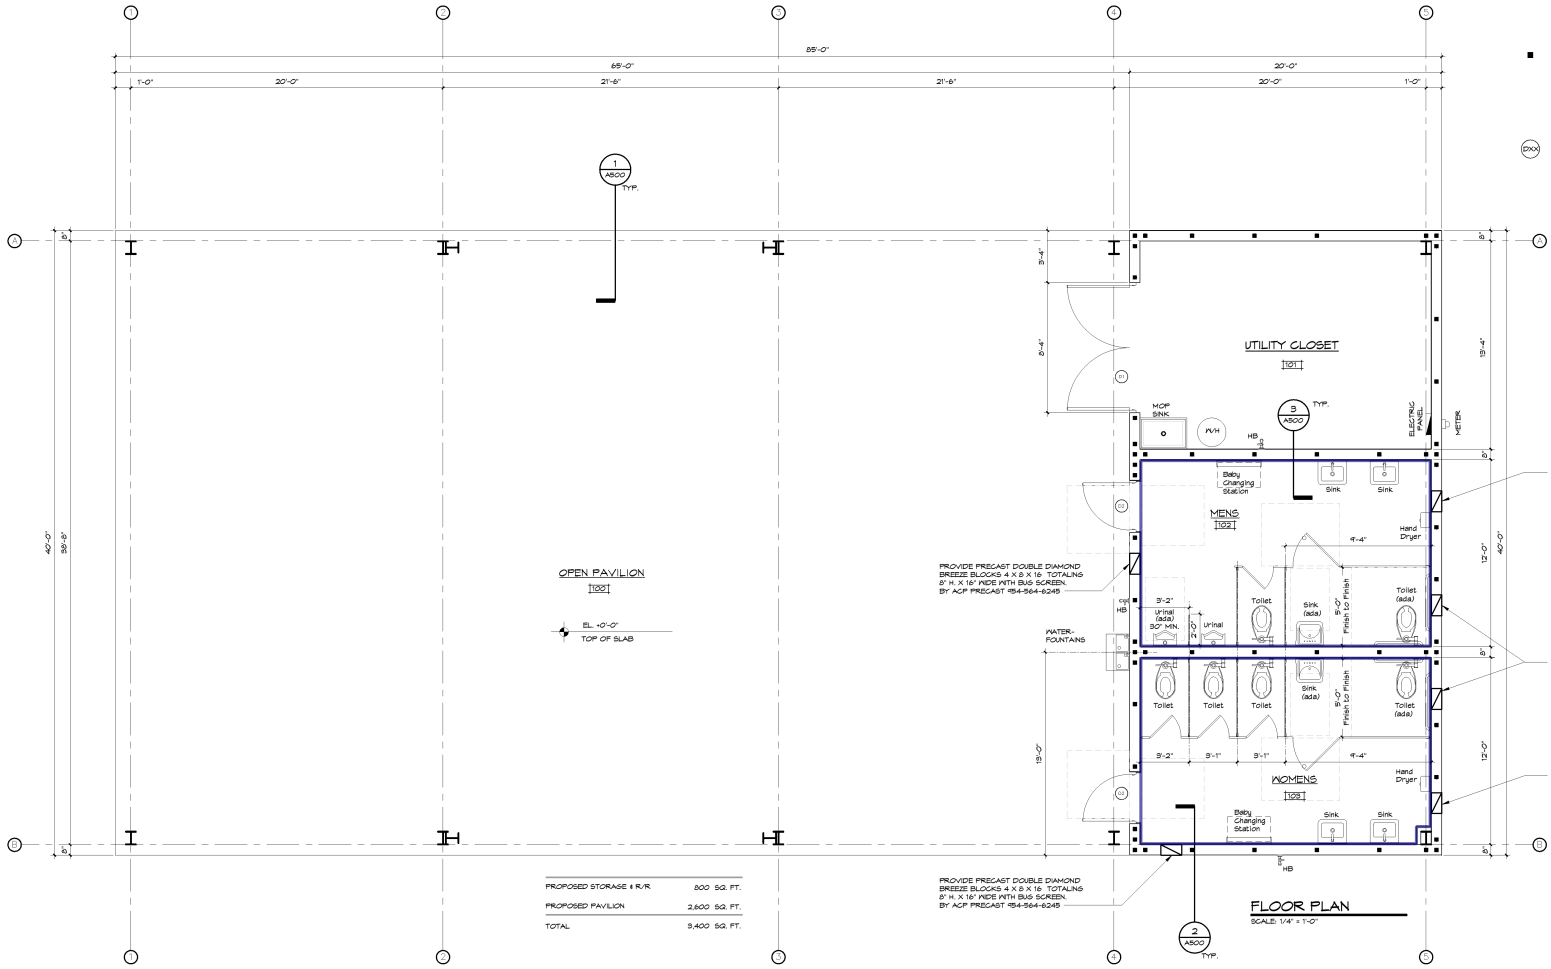

PROPOSED STORAGE # R/R	800 SQ. FT.
PROPOSED PAVILION	2,600 SQ. FT.
TOTAL	3,400 SQ. FT.

PROVIDE PRECAST DOUBLE DIAMOND BREEZE BLOCKS 4 X 8 X 16, TOTALING 2" H. X 16" WIDE WITH BUS SCREEN. BY ASP PRECAST 184-564-6245

PROVIDE PRECAST DOUBLE DIAMOND BREEZE BLOCKS 4 X 8 X 16, TOTALING 2" H. X 16" WIDE WITH BUS SCREEN. BY ASP PRECAST 184-564-6245

PROVIDE PRECAST DOUBLE DIAMOND BREEZE BLOCKS 4 X 8 X 16, TOTALING 2" H. X 16" WIDE WITH BUS SCREEN. BY ASP PRECAST 184-564-6245

PROVIDE PRECAST DOUBLE DIAMOND BREEZE BLOCKS 4 X 8 X 16, TOTALING 2" H. X 16" WIDE WITH BUS SCREEN. BY ASP PRECAST 184-564-6245

**FLOOR PLAN**  
 SCALE: 1/4" = 1'-0"

102 MENS WALL	60.8 FT
103 WOMENS TOILET WALL	60.8 FT