

REUSE OF DOCUMENTS: CH2M HILL AND ITS CLIENTS ARE REQUESTING THAT ANY REUSE OF THIS DOCUMENT BE IN FULL COMPLIANCE WITH THE ORIGINAL INTENT AND PURPOSE OF THE DOCUMENT. ANY REUSE OF THIS DOCUMENT WITHOUT THE WRITTEN AUTHORIZATION OF CH2M HILL IS PROHIBITED.

DESIGN	M. THUR
DR	2/21/2001
CHK	S.A. MCCOY
APPROV	M. THUR

NO.	DATE	REVISION	BY	APPV

**VERIFY SCALE**  
 BAR IS ONE INCH ON ORIGINAL DRAWING  
 IF NOT ONE INCH ON THIS SHEET, ADJUST SCALES ACCORDINGLY.

**CH2MHILL**  
 3011 SW WILLISTON ROAD  
 GAINESVILLE, FLORIDA 32608  
 EB0000072 ACC001992




WATER RECLAMATION FACILITY No. 3  
 CITY OF OCALA, FLORIDA

DEWATERING BUILDING STRUCTURAL FOUNDATION, FIRST FLOOR PLAN, FOOTING SCHEDULE AND COLUMN SCHEDULE


SHEET	151
DWG	6-S-1
DATE	FEBRUARY 2001
PROJ	15B211.TL.CD

01-MAR-2001 13:01:06 0211105016.dgn



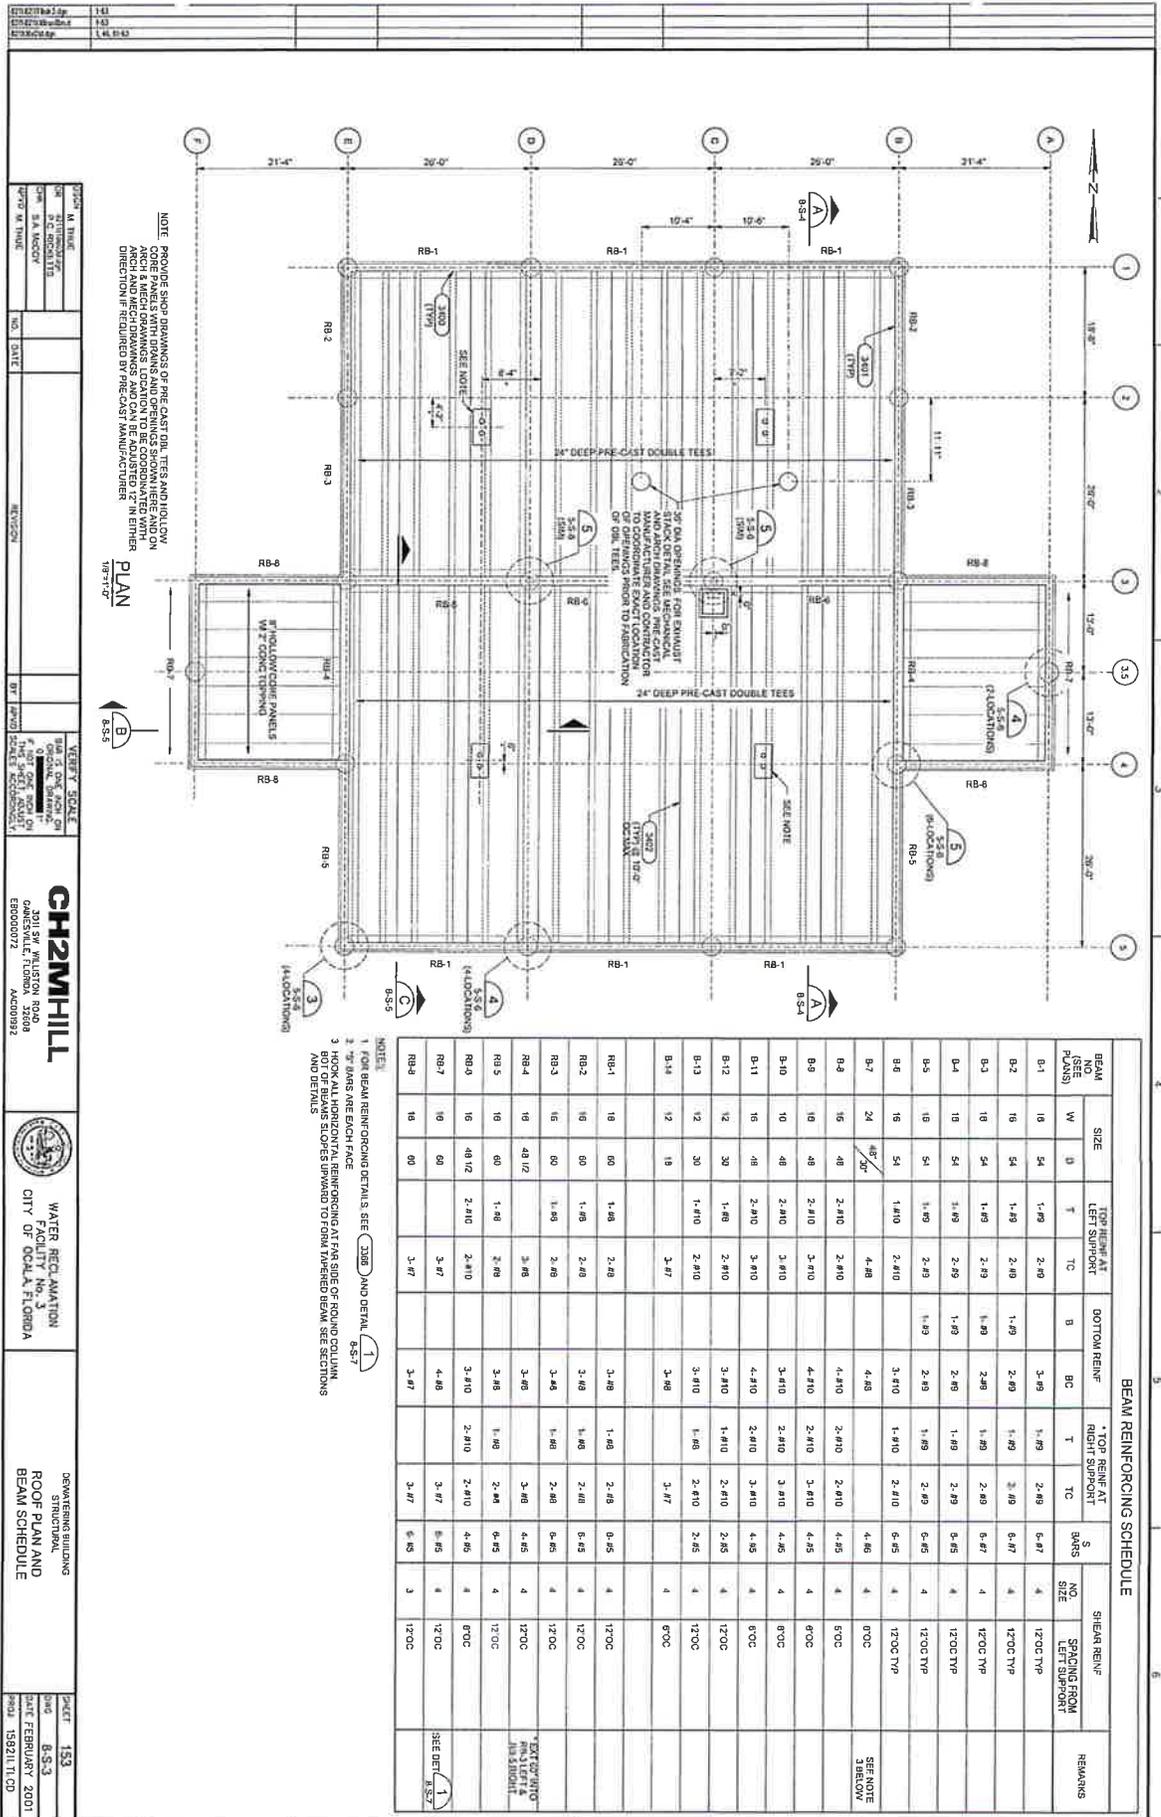

REUSE OF DOCUMENTS: THIS DOCUMENT AND THE IDEAS AND DESIGNS INCORPORATED HEREIN AS AN INSTRUMENT OF PROFESSIONAL SERVICE IS THE PROPERTY OF CH2M HILL AND IS NOT TO BE USED, IN WHOLE OR IN PART, FOR ANY OTHER PROJECT WITHOUT THE WRITTEN AUTHORIZATION OF CH2M HILL.

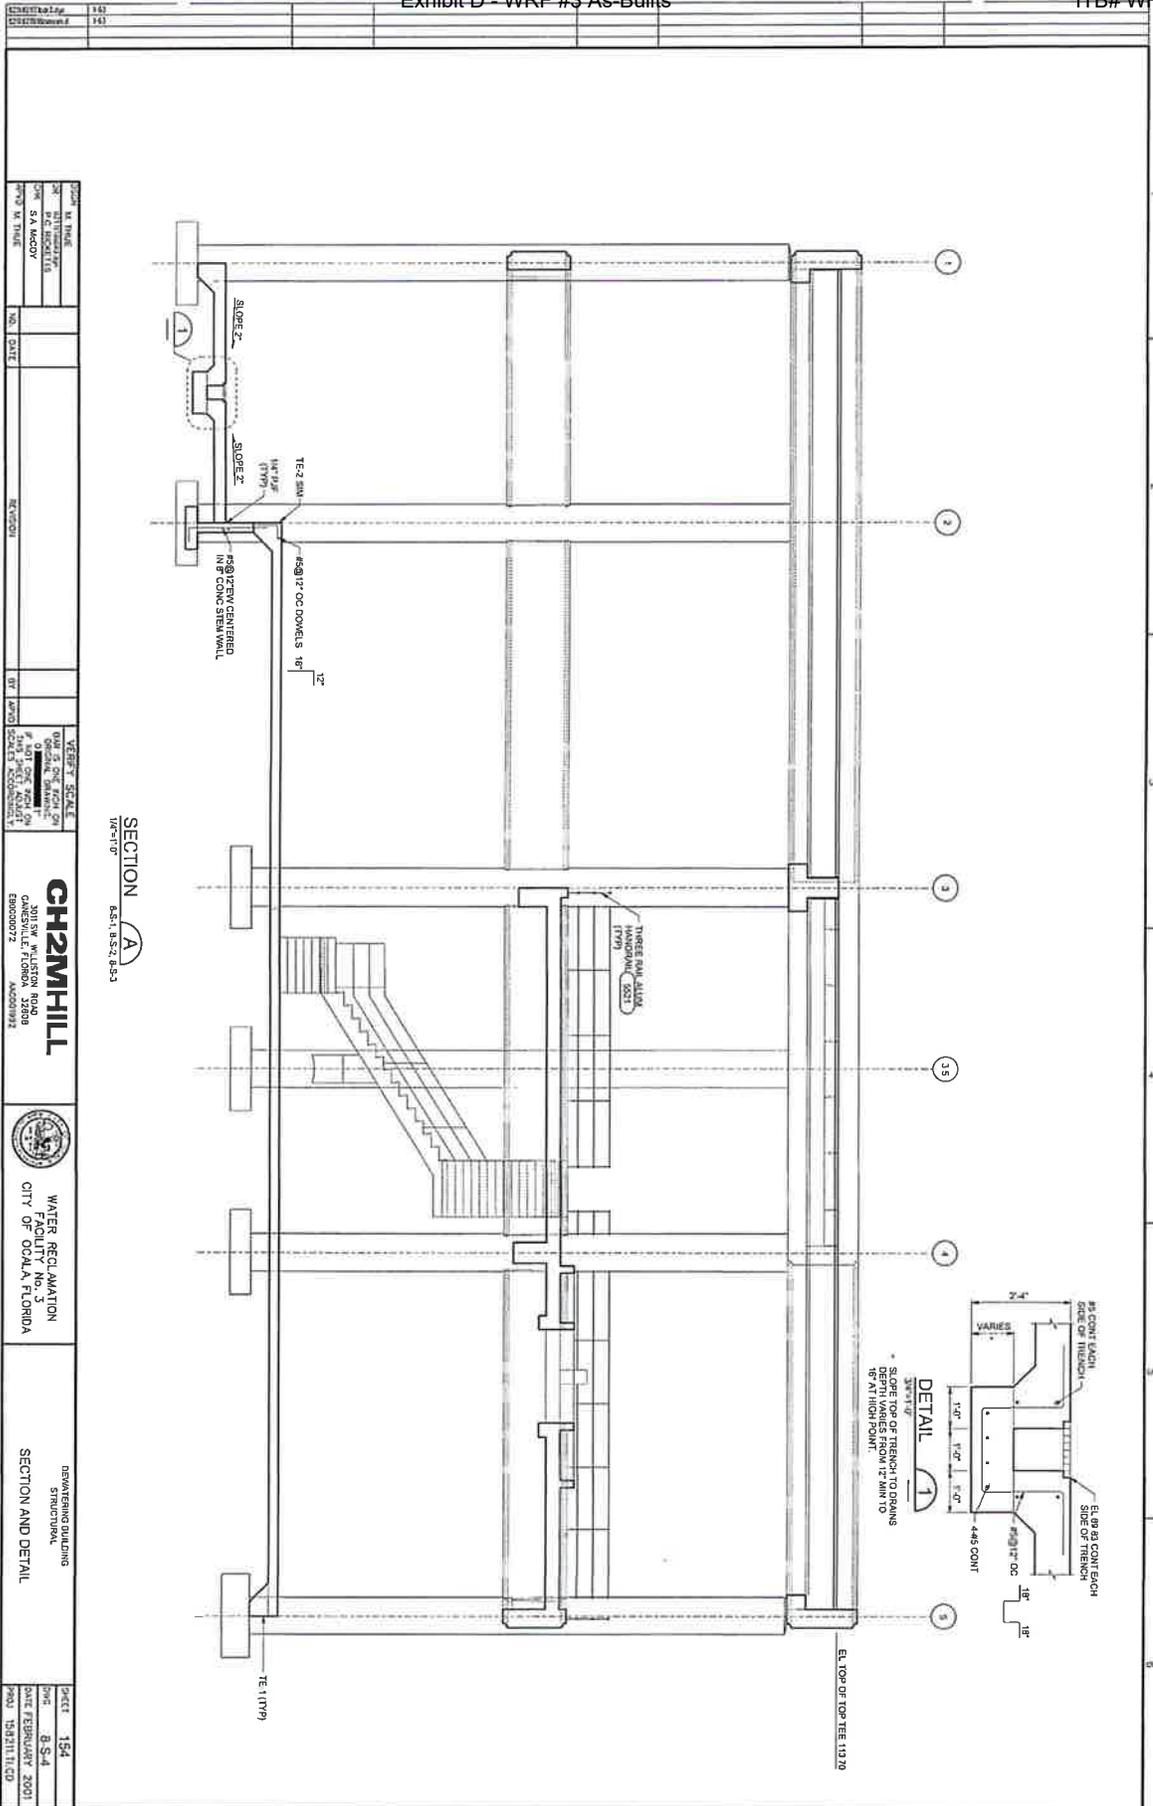

DESIGNED BY R.C. BOWEN	CHECKED BY S.A. MCOY	DATE NO. DATE	REVISION	VERTICAL SCALE 1" = 1'-0"	CH2MHILL 301 SW WILSTON ROAD GAINESVILLE, FLORIDA 32609 889.237.2	WATER RECLAMATION FACILITY No. 3 CITY OF COALA FLORIDA	DEWATERING BUILDING STRUCTURAL SECTION AND DETAIL	SHEET 154 OF 154 DATE FEBRUARY 2001 PROJ 1535111100
---------------------------	-------------------------	------------------	----------	------------------------------	--	--	---	--

BID DOCUMENTS REUSE OF DOCUMENTS: THIS DOCUMENT AND THE IDEAS AND DESIGNS INCORPORATED HEREIN, AS AN INSTRUMENT OF PROFESSIONAL SERVICE IS THE PROPERTY OF CH2M HILL AND IS NOT TO BE USED IN WHOLE OR IN PART FOR ANY OTHER PROJECT WITHOUT THE WRITTEN AUTHORIZATION OF CH2M HILL





