

	DESIGN	B. WHITE
	FOR REVIEW	M. PASTERIS
	CHK	J. CAVE
	APPROV	M. DUVENACK

NO.	DATE	REVISION	BY	APPROV
9-80		CHANGED CMU TO 12"	ETE	
9-80		CHANGED GUARDPOST DETAIL	ETE	


REUSE OF DOCUMENTS
 THIS DOCUMENT AND THE IDEAS AND DESIGNS INCORPORATED HEREIN AS AN INSTRUMENT OF PROFESSIONAL SERVICE, IS THE PROPERTY OF CH2M HILL AND IS NOT TO BE REPRODUCED, COPIED, OR IN ANY MANNER FOR ANY OTHER PROJECT WITHOUT THE WRITTEN AUTHORIZATION OF CH2M HILL.
 CH2M HILL


THIS IS ONE COPY OF ORIGINAL DRAWING.
 IF YOU SEE ONE MORE COPY OF THIS SHEET ADJUST YOUR RECORDS ACCORDINGLY.

WATER RECLAMATION
 FACILITY NO. 2
 CITY OF OCALA, FLORIDA


DEWATERING BUILDING FIRST FLOOR PLAN	SHEET 29
	DWG. A-3
	DATE JULY 1980
	PROJ. NO. QNV28703.B3

AS-BUILT
 3-91 W.R.

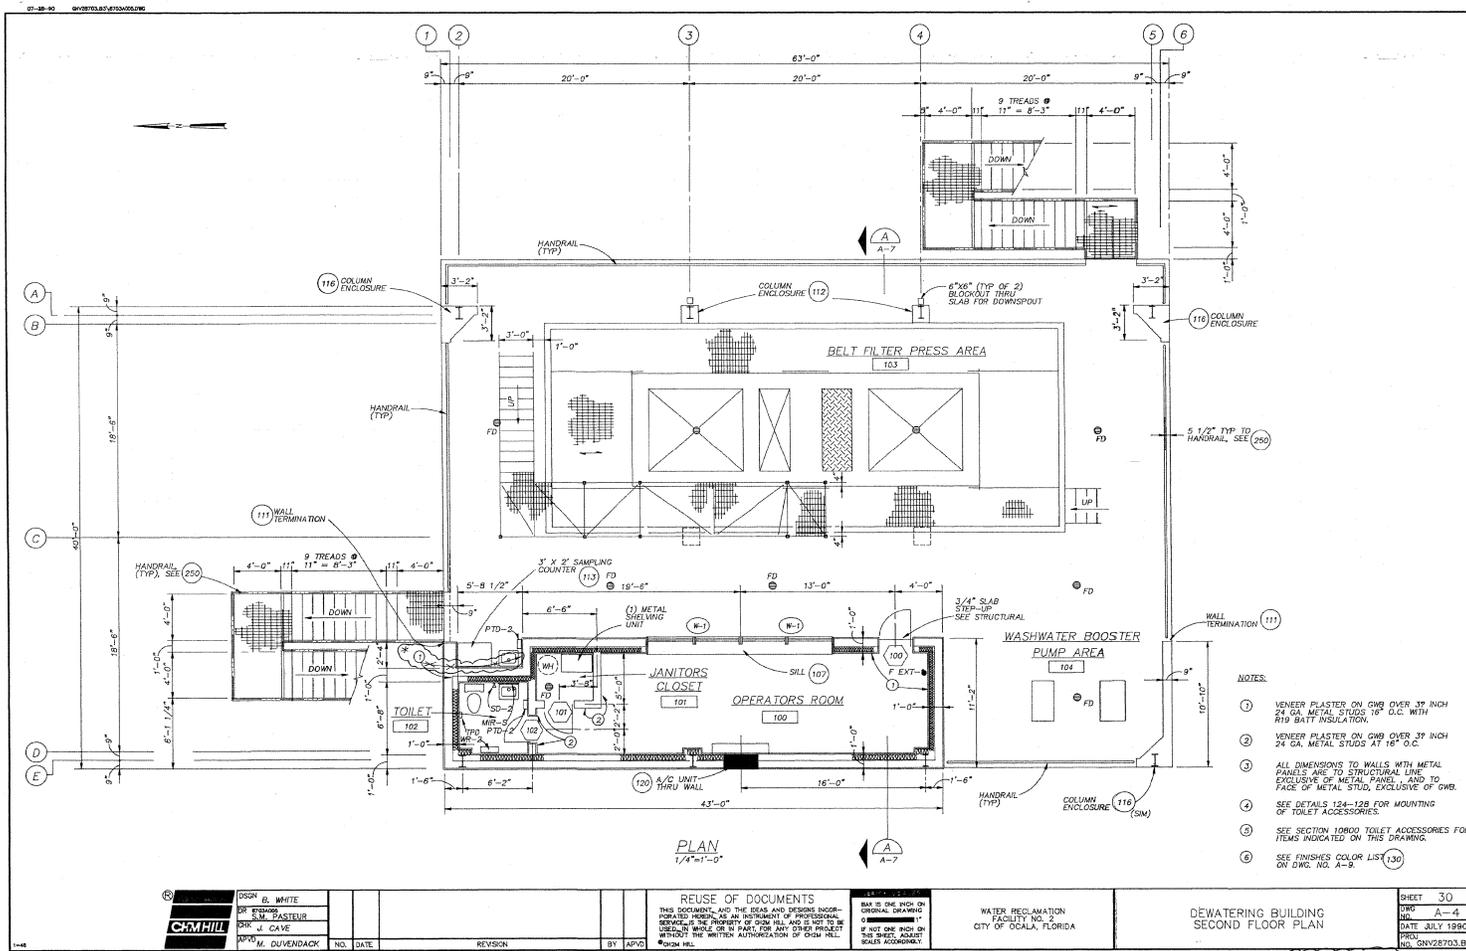

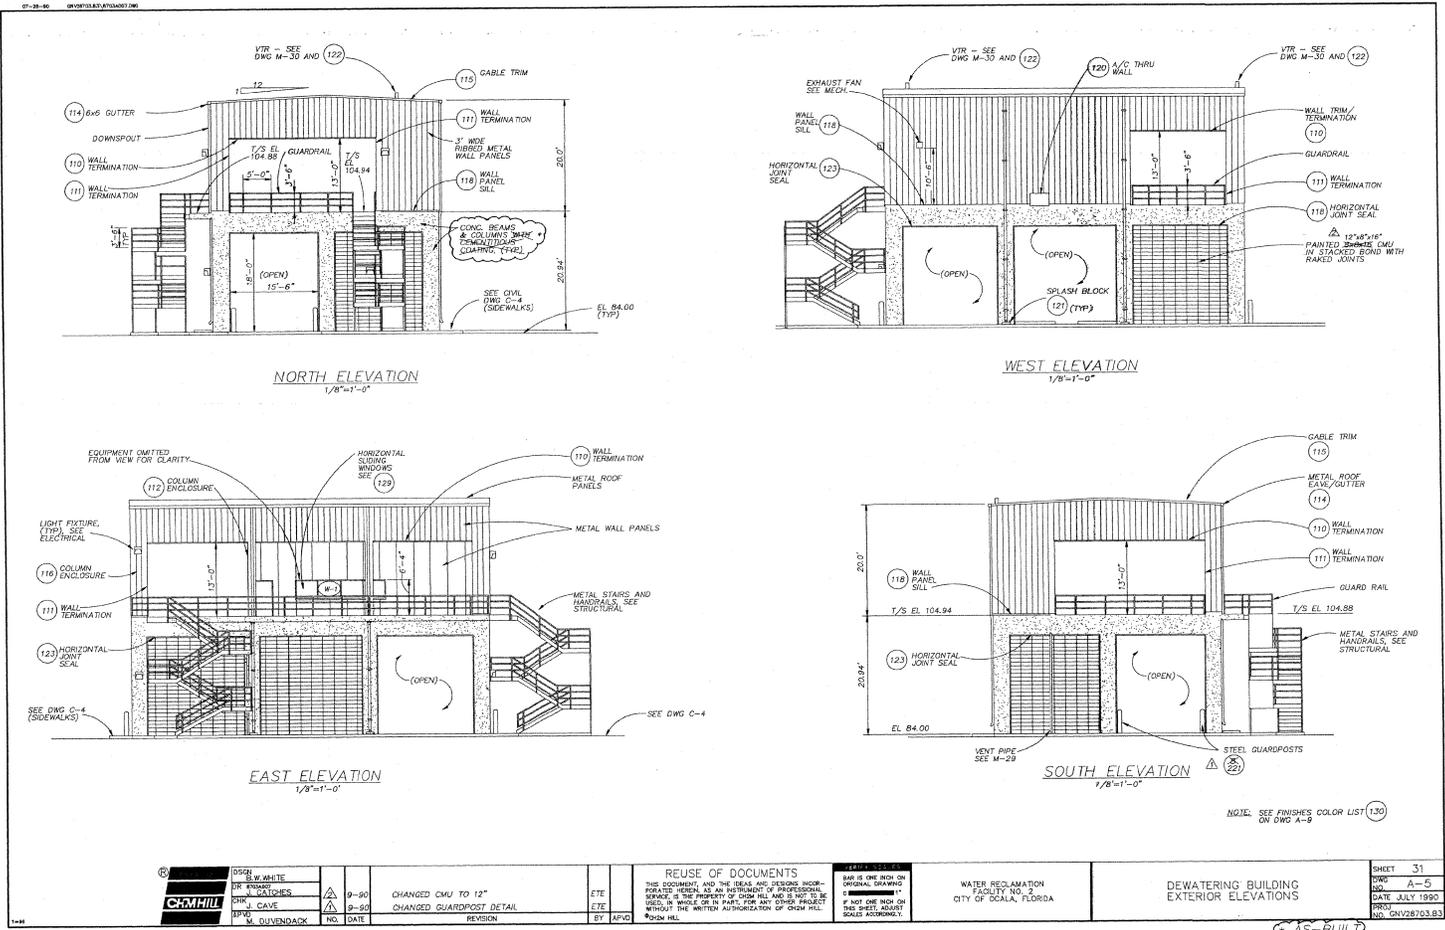

AS-BUILT
3-93 W.B.

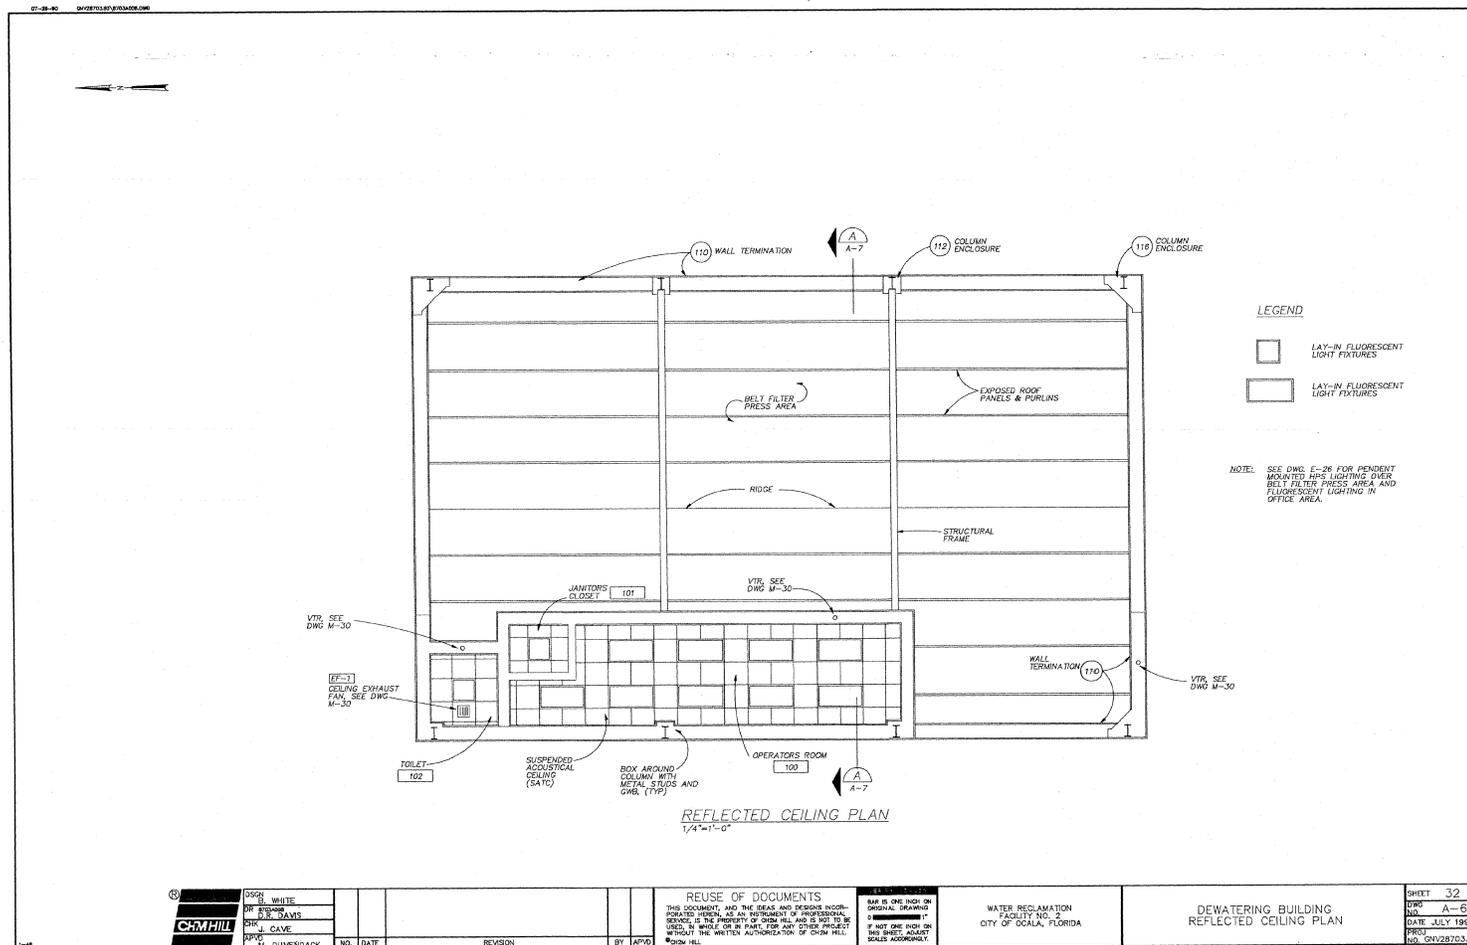

	DESIGN	WHITE
	BY	RYAN
	CHECKED	CAVE
	DATE	M. DUVERDACK

NO.	DATE	REVISION	BY	APP'D

REUSE OF DOCUMENTS
 THIS DOCUMENT AND THE SEALS AND SIGNS INCORPORATED HEREIN, AS AN INSTRUMENT OF PROFESSIONAL SERVICE, IS THE PROPERTY OF CH2M HILL AND IS NOT TO BE USED, IN WHOLE OR IN PART, FOR ANY OTHER PROJECT WITHOUT THE WRITTEN AUTHORIZATION OF CH2M HILL.


BAR IN ONE INCH ON ORIGINAL DRAWING IS EQUIVALENT TO 1/8\"/>

WATER RECLAMATION FACILITY NO. 2
 CITY OF OCALA, FLORIDA

DEWATERING BUILDING
 REFLECTED CEILING PLAN

SHEET	32
DATE	AUGUST 1990
PROJECT NO.	GRV28703.B3

* AS-BUILT 3-93 W.B.

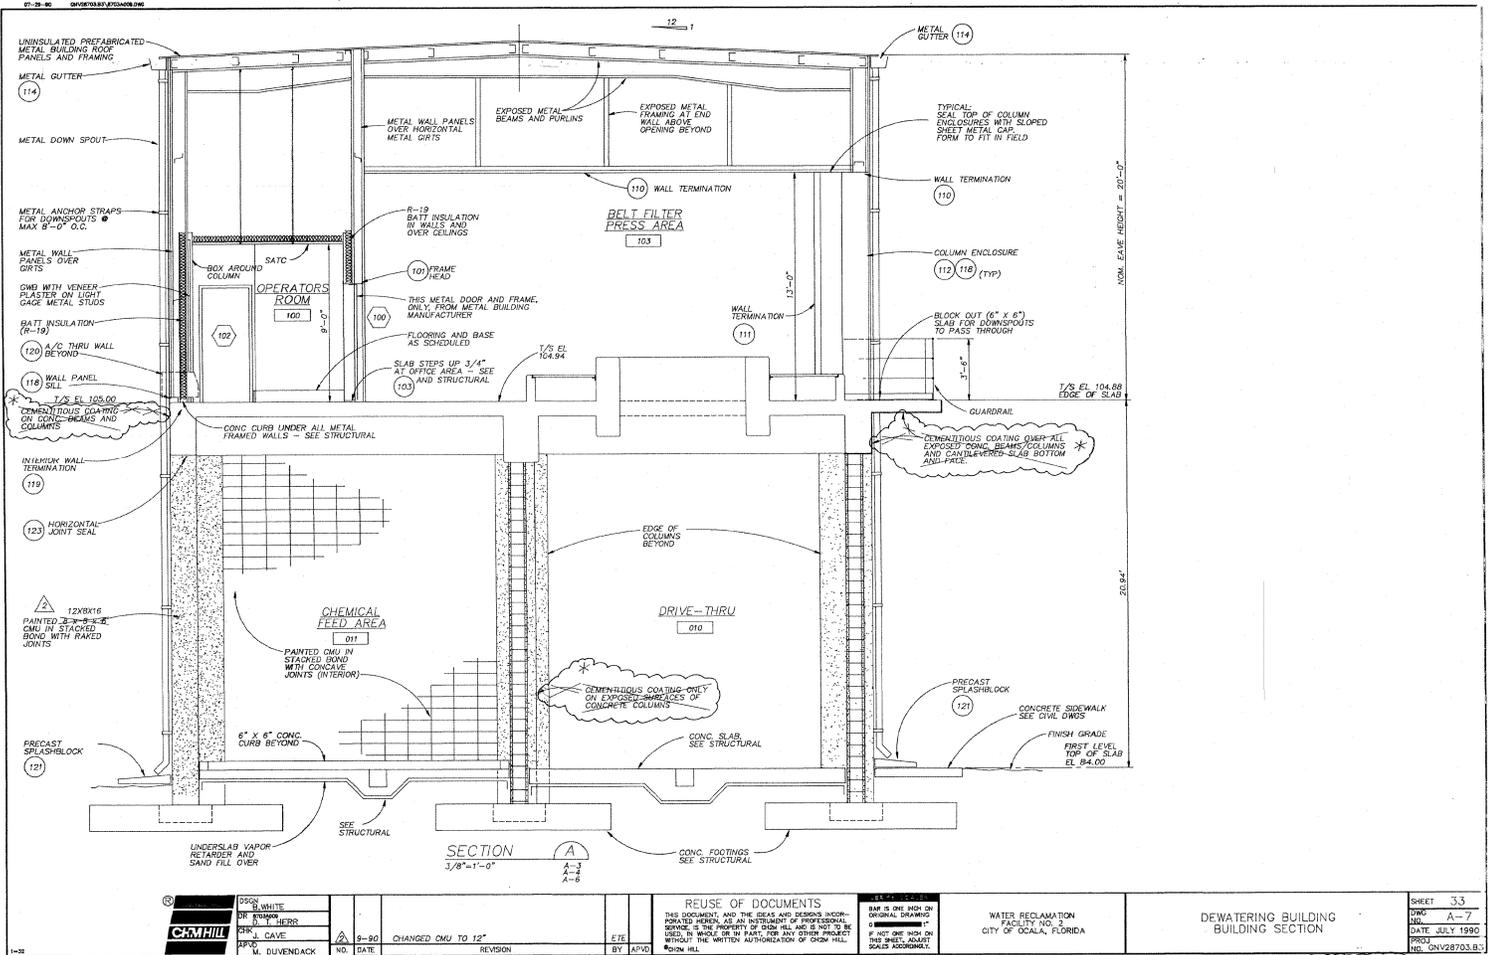

	DESIGN	BY WHITE
	DR. ENGINEER	BY HERR
	SEAL	BY GAYE
	APPROVED	BY DUVENACK

NO.	DATE	REVISION	BY
8-90		CHANGED CMU TO 12"	ETE
			BY APGD

REUSE OF DOCUMENTS
 THIS DOCUMENT AND THE IDEAS AND DESIGNS INCORPORATED HEREIN ARE AN INSTRUMENT OF PROFESSIONAL SERVICE IN THE PROPERTY OF CH2M HILL AND ARE NOT TO BE USED IN WHOLE OR IN PART FOR ANY OTHER PROJECT WITHOUT THE WRITTEN AUTHORIZATION OF CH2M HILL.

SCALE
 BAR IS ONE INCH ON ORIGINAL DRAWING
 WATER RECLAMATION FACILITY NO. 2
 CITY OF OCALA, FLORIDA

DEWATERING BUILDING BUILDING SECTION		SHEET 33
		NO. A-7
		DATE JULY 1990
		PROJ. NO. 02V28703.B

AS-BUILT
 3-93 W.B.