



	DESIGN	KLAUS	8/90 DELETED FLEX CPLG. ADDED RESTRAINED M.A. ADDED 1" PO	NO. DATE REVISION	JK MD	REUSE OF DOCUMENTS THIS DOCUMENT AND THE DEAS AND DESIGN INCORPORATED HEREIN, AS AN INSTRUMENT OF PROFESSIONAL SERVICE, IS THE PROPERTY OF CH2M HILL AND IS NOT TO BE REPRODUCED OR TRANSMITTED IN ANY FORM OR BY ANY MEANS, ELECTRONIC OR MECHANICAL, WITHOUT THE WRITTEN APPROVAL OF CH2M HILL.	SHEET NO. 97 DATE JULY 1990 PROJ. NO. 260536.03	WATER RECLAMATION FACILITY NO. 2 CITY OF OCALA, FLORIDA	DEWATERING BUILDING SECTIONS AND DETAILS	SHEET M-27
	DR	WYNN								




	DSSN: KLAUS DR: STINE CRK: B. HARRIS APK: M. DUVENDACK	NO. 8/90 DATE	REVISION REPLACED GLOBE VALVES WITH BALL VALVES, ADDED 2" W3 LABEL, CHANGED 2" PO TO 2" LPO, ADDED LPO AND 1" PO PIPES AND VALVES	BY: AP/GO	REUSE OF DOCUMENTS THIS DOCUMENT AND THE IDEAS AND DESIGN INFORMATION HEREIN, AS AN INSTRUMENT OF PROFESSIONAL SERVICE, IS THE PROPERTY OF CH2M HILL AND IS NOT TO BE USED IN WHOLE OR IN PART, FOR ANY OTHER PROJECT WITHOUT THE WRITTEN APPROVAL OF CH2M HILL.	DATE: JULY 1990 PROJECT NO. 04V28703.B3	WATER RECLAMATION FACILITY NO. 2 CITY OF OCALA, FLORIDA	DEWATERING BUILDING SCHEMATICS	SHEET 98 OF M-28
	* AS-BUILT 3-93 W.B.								

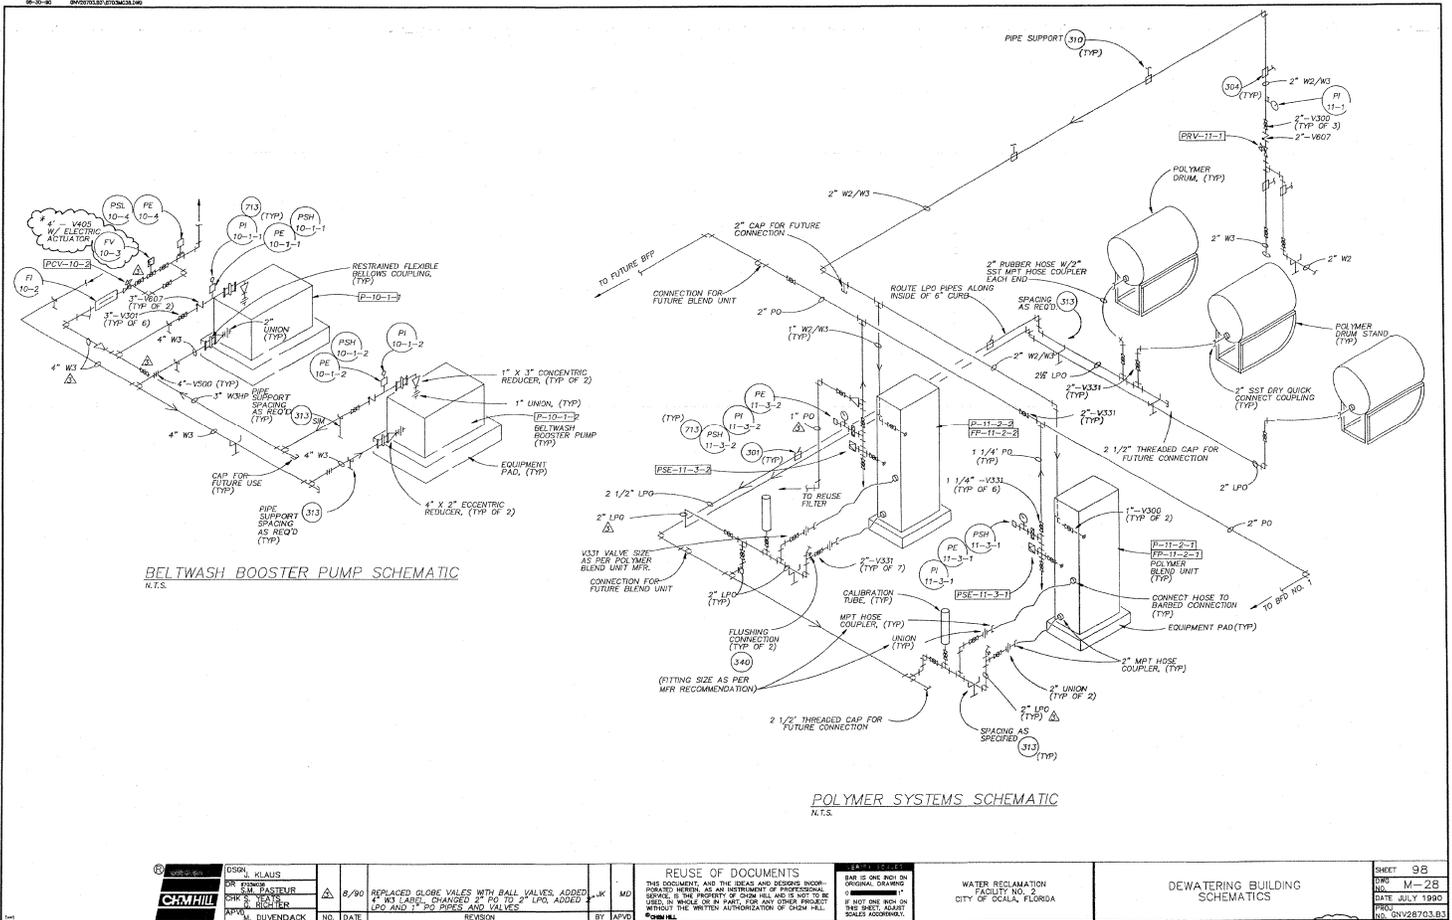

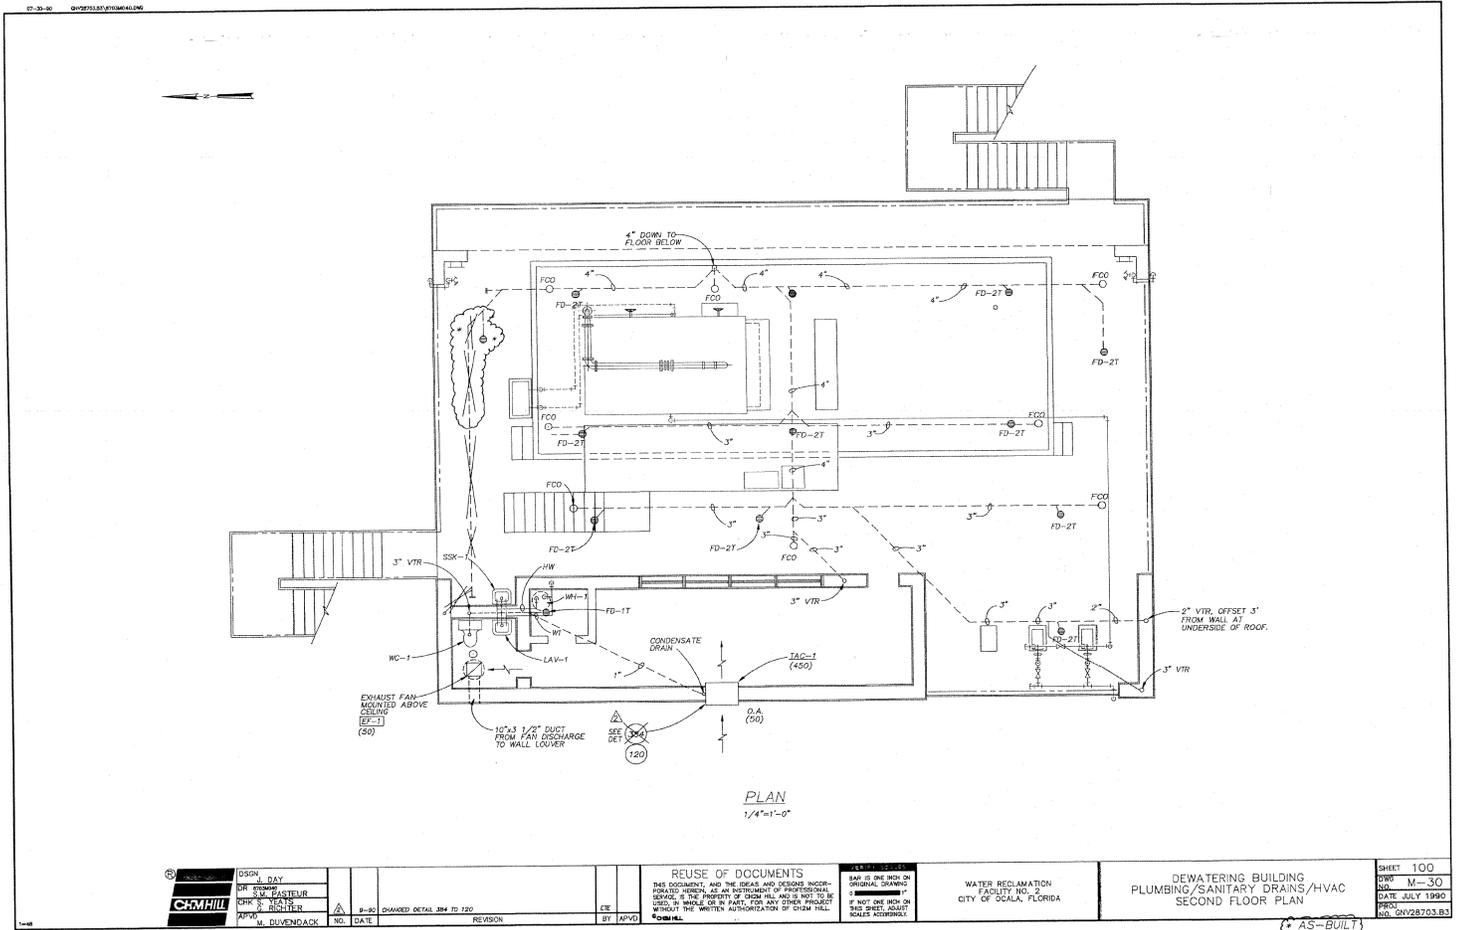

AS-BUILT  
3-93 W.B.

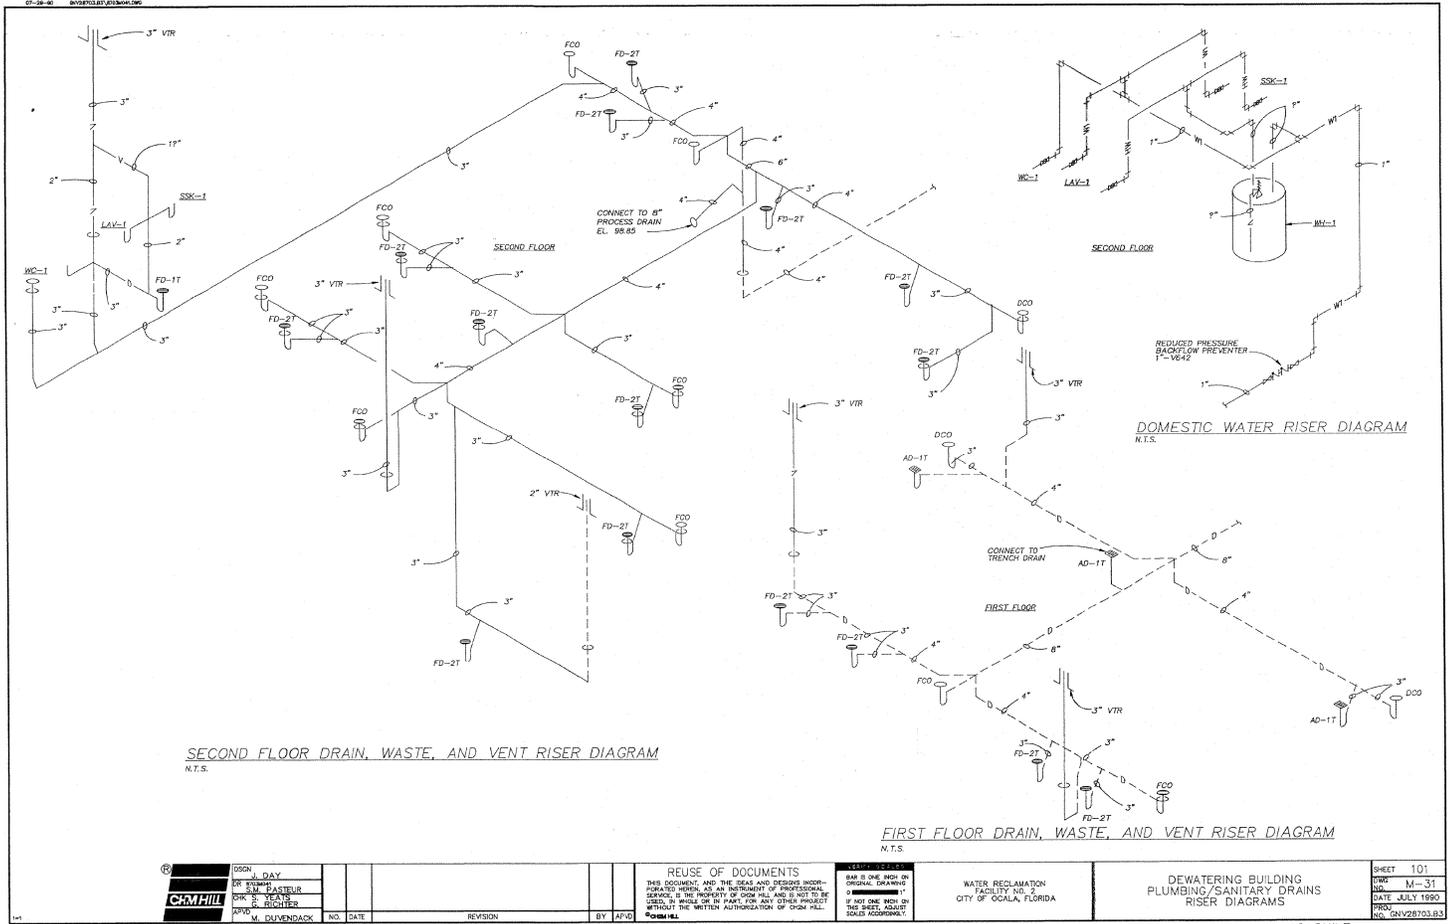

	DESIGN	J. DAY							<b>REUSE OF DOCUMENTS</b> THIS DOCUMENT AND THE IDEAS AND DESIGN HEREIN, FORWARDED HEREIN, ARE AN INSTRUMENT OF PROFESSIONAL SERVICE, IS THE PROPERTY OF CH2M HILL AND IS NOT TO BE USED, IN WHOLE OR IN PART, FOR ANY OTHER PROJECT WITHOUT THE WRITTEN AUTHORIZATION OF CH2M HILL.	SHALL BE ONE INCH ON ORIGINAL DRAWING.	WATER RECLAMATION FACILITY NO. 2 CITY OF OCALA, FLORIDA	DEWATERING BUILDING PLUMBING/SANITARY DRAINS RISER DIAGRAMS	SHEET	101
	DRAWN	M. BASTIER											DATE	3-93
	CHECKED	R. RICHARDS											PROJ.	WRS/260536.83
	APPROVED	M. BLUMENBACH	NO.	DATE	REVISION	BY	APPROVED							

\* AS-BUILT  
3-93 W.B.