



AS BUILT		Customer Name			
SIGN		<i>Design Description</i>			
DATE				1805 NE 30 AVE Ocala, FL 34470 PH: (352) 351-6620 FX: (352) 401-6961	Proj #Project Number Ckt: First Feeder ID W#Order Number Eng: JConstable FO#: Field Order ID Date: 3/14/2024
LOCATES: YES	1" = 60'				

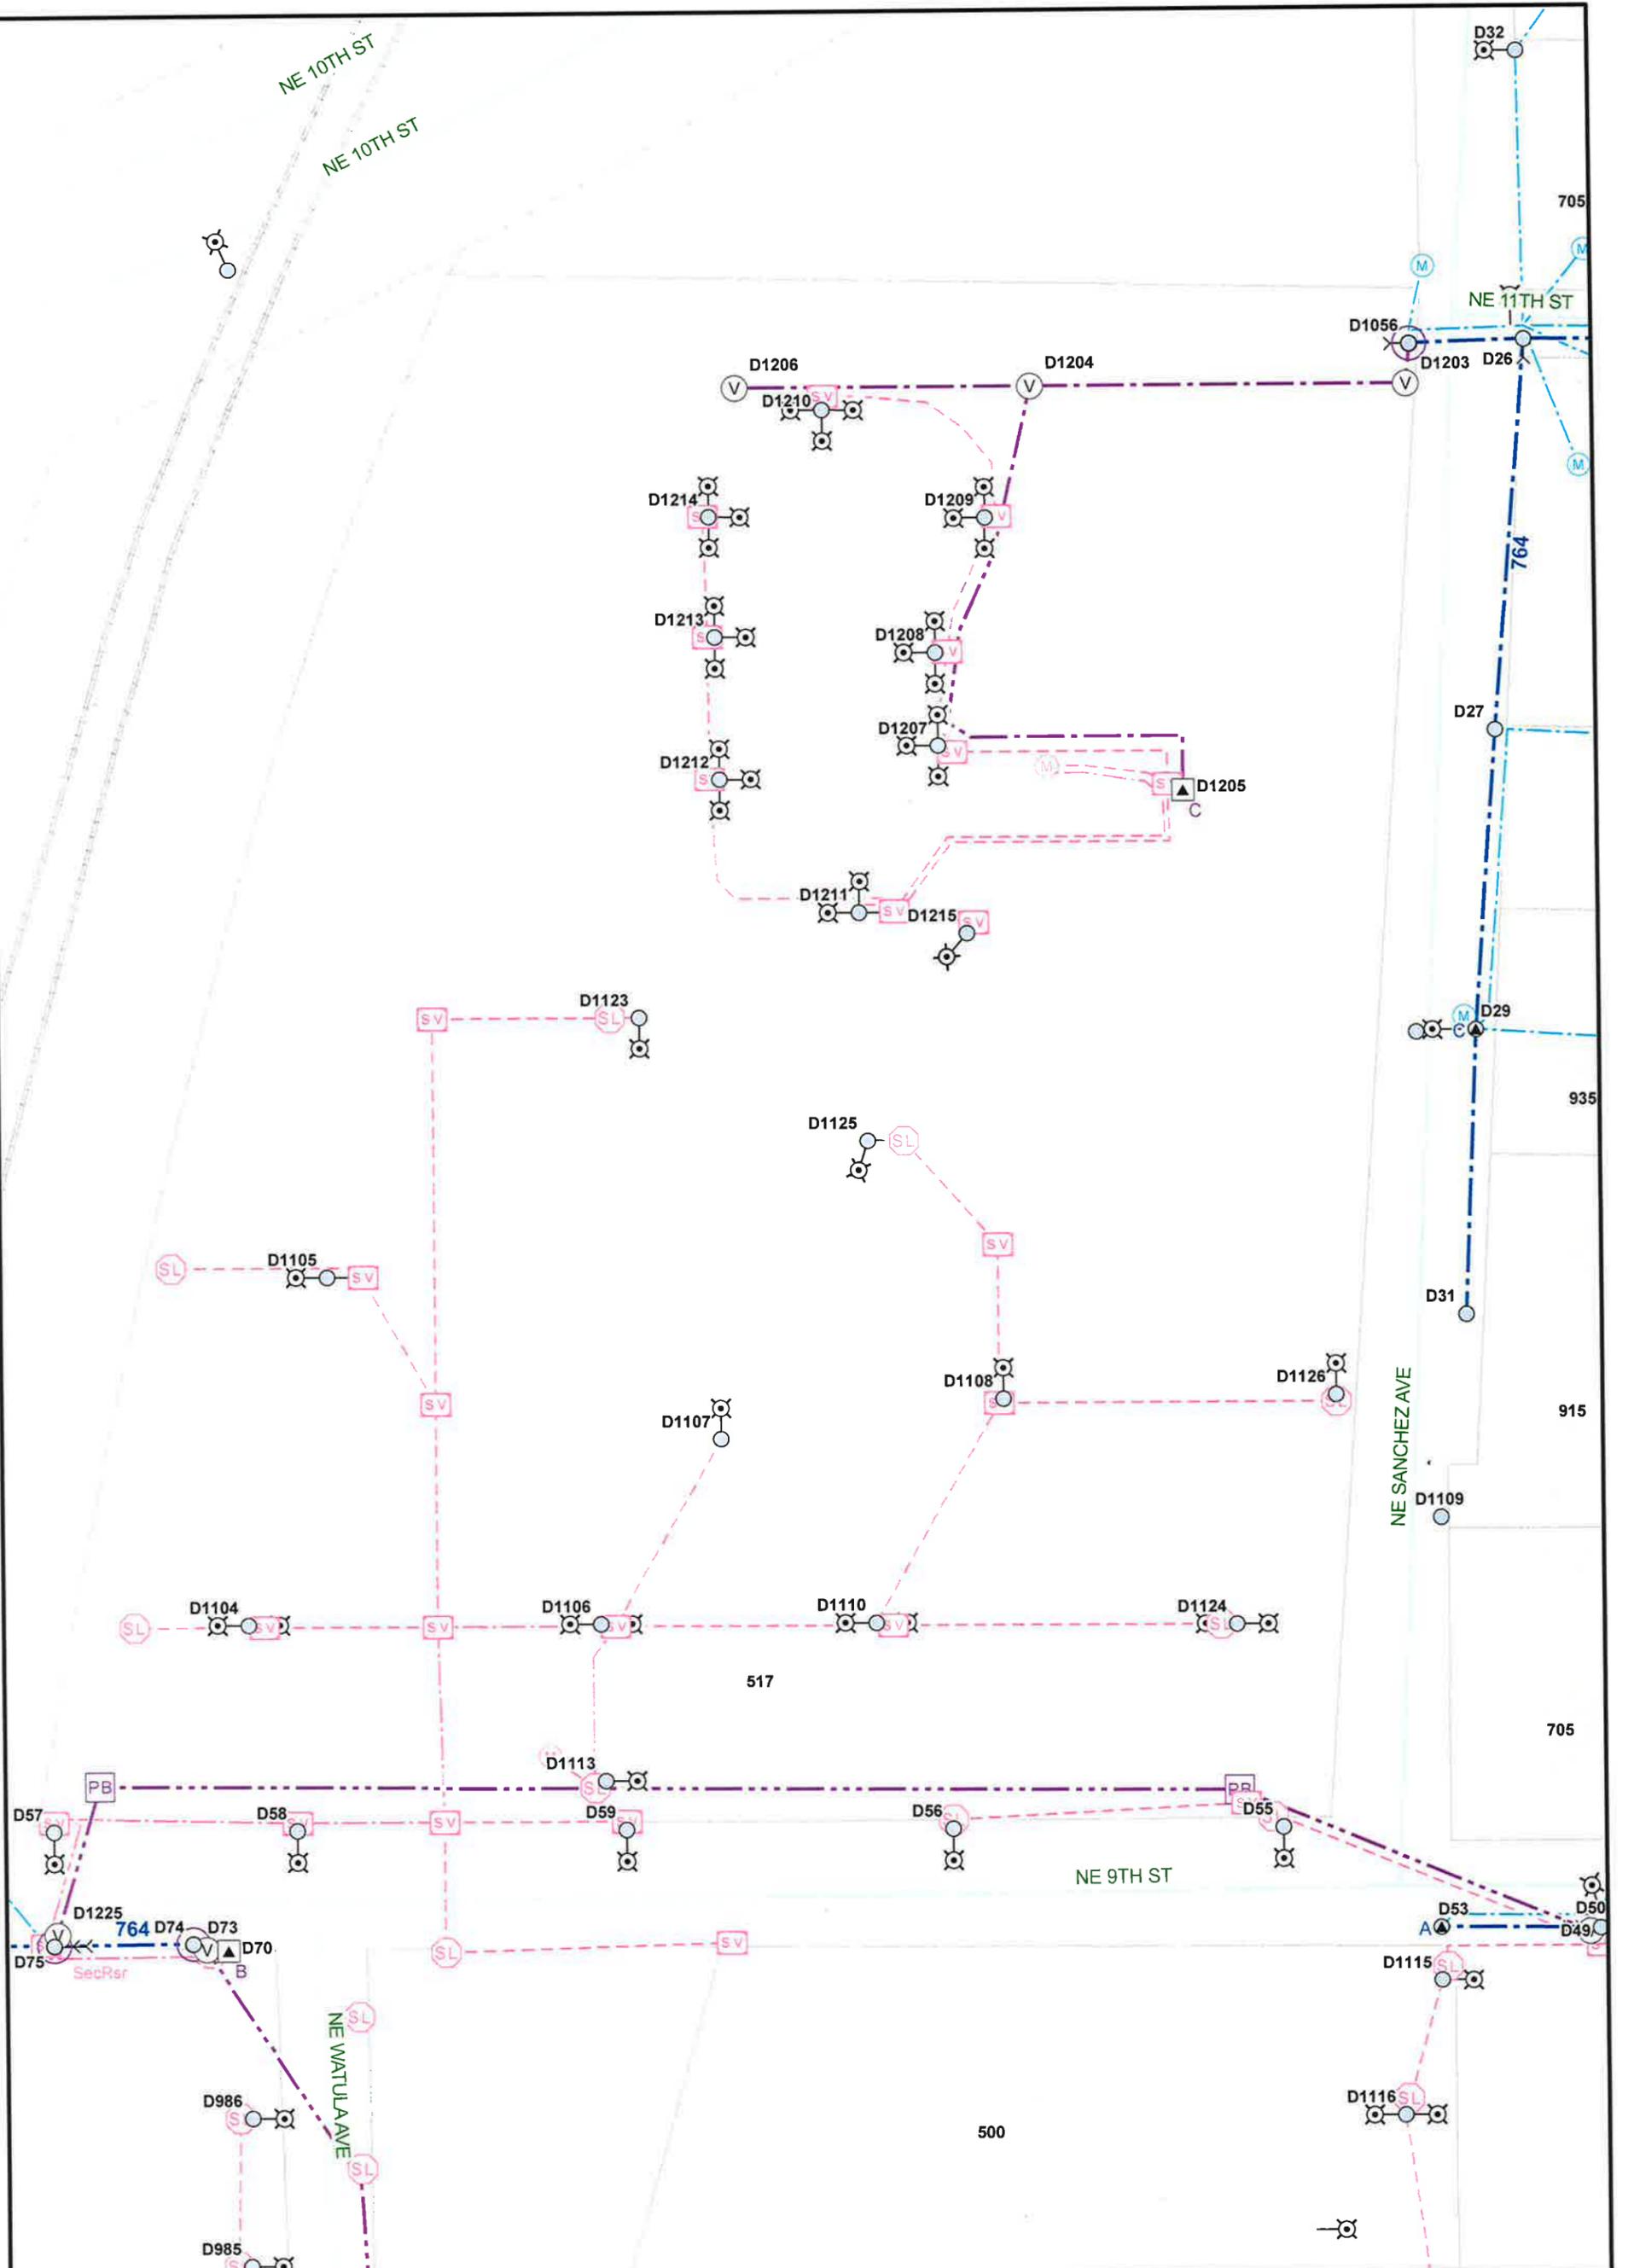

<p>AS BUILT</p> <p>SIGN</p> <p>DATE</p> <p>LOCATES: YES</p>	<p>1" = 60'</p>	<p align="center">Customer Name</p> <p align="center"><i>Design Description</i></p> <table border="1"> <tr> <td data-bbox="594 2874 917 3014"> </td> <td data-bbox="917 2874 1139 3014"> <p>1805 NE 30 AVE OCALA, FL 34470</p> <p>PH: (352) 351-6620 FX: (352) 401-6961</p> </td> <td data-bbox="1139 2874 1340 3014"> <p>Prj #Project Number</p> <p>WO#Order Number</p> <p>FO#: Field Order ID</p> </td> <td data-bbox="1340 2874 1542 3014"> <p>Ckt: First Feeder ID</p> <p>Eng: JConstable</p> <p>Date: 3/14/2024</p> </td> <td data-bbox="1542 2874 1965 3014"> <p>Location Address</p> </td> </tr> </table>					<p>1805 NE 30 AVE OCALA, FL 34470</p> <p>PH: (352) 351-6620 FX: (352) 401-6961</p>	<p>Prj #Project Number</p> <p>WO#Order Number</p> <p>FO#: Field Order ID</p>	<p>Ckt: First Feeder ID</p> <p>Eng: JConstable</p> <p>Date: 3/14/2024</p>	<p>Location Address</p>
	<p>1805 NE 30 AVE OCALA, FL 34470</p> <p>PH: (352) 351-6620 FX: (352) 401-6961</p>	<p>Prj #Project Number</p> <p>WO#Order Number</p> <p>FO#: Field Order ID</p>	<p>Ckt: First Feeder ID</p> <p>Eng: JConstable</p> <p>Date: 3/14/2024</p>	<p>Location Address</p>						

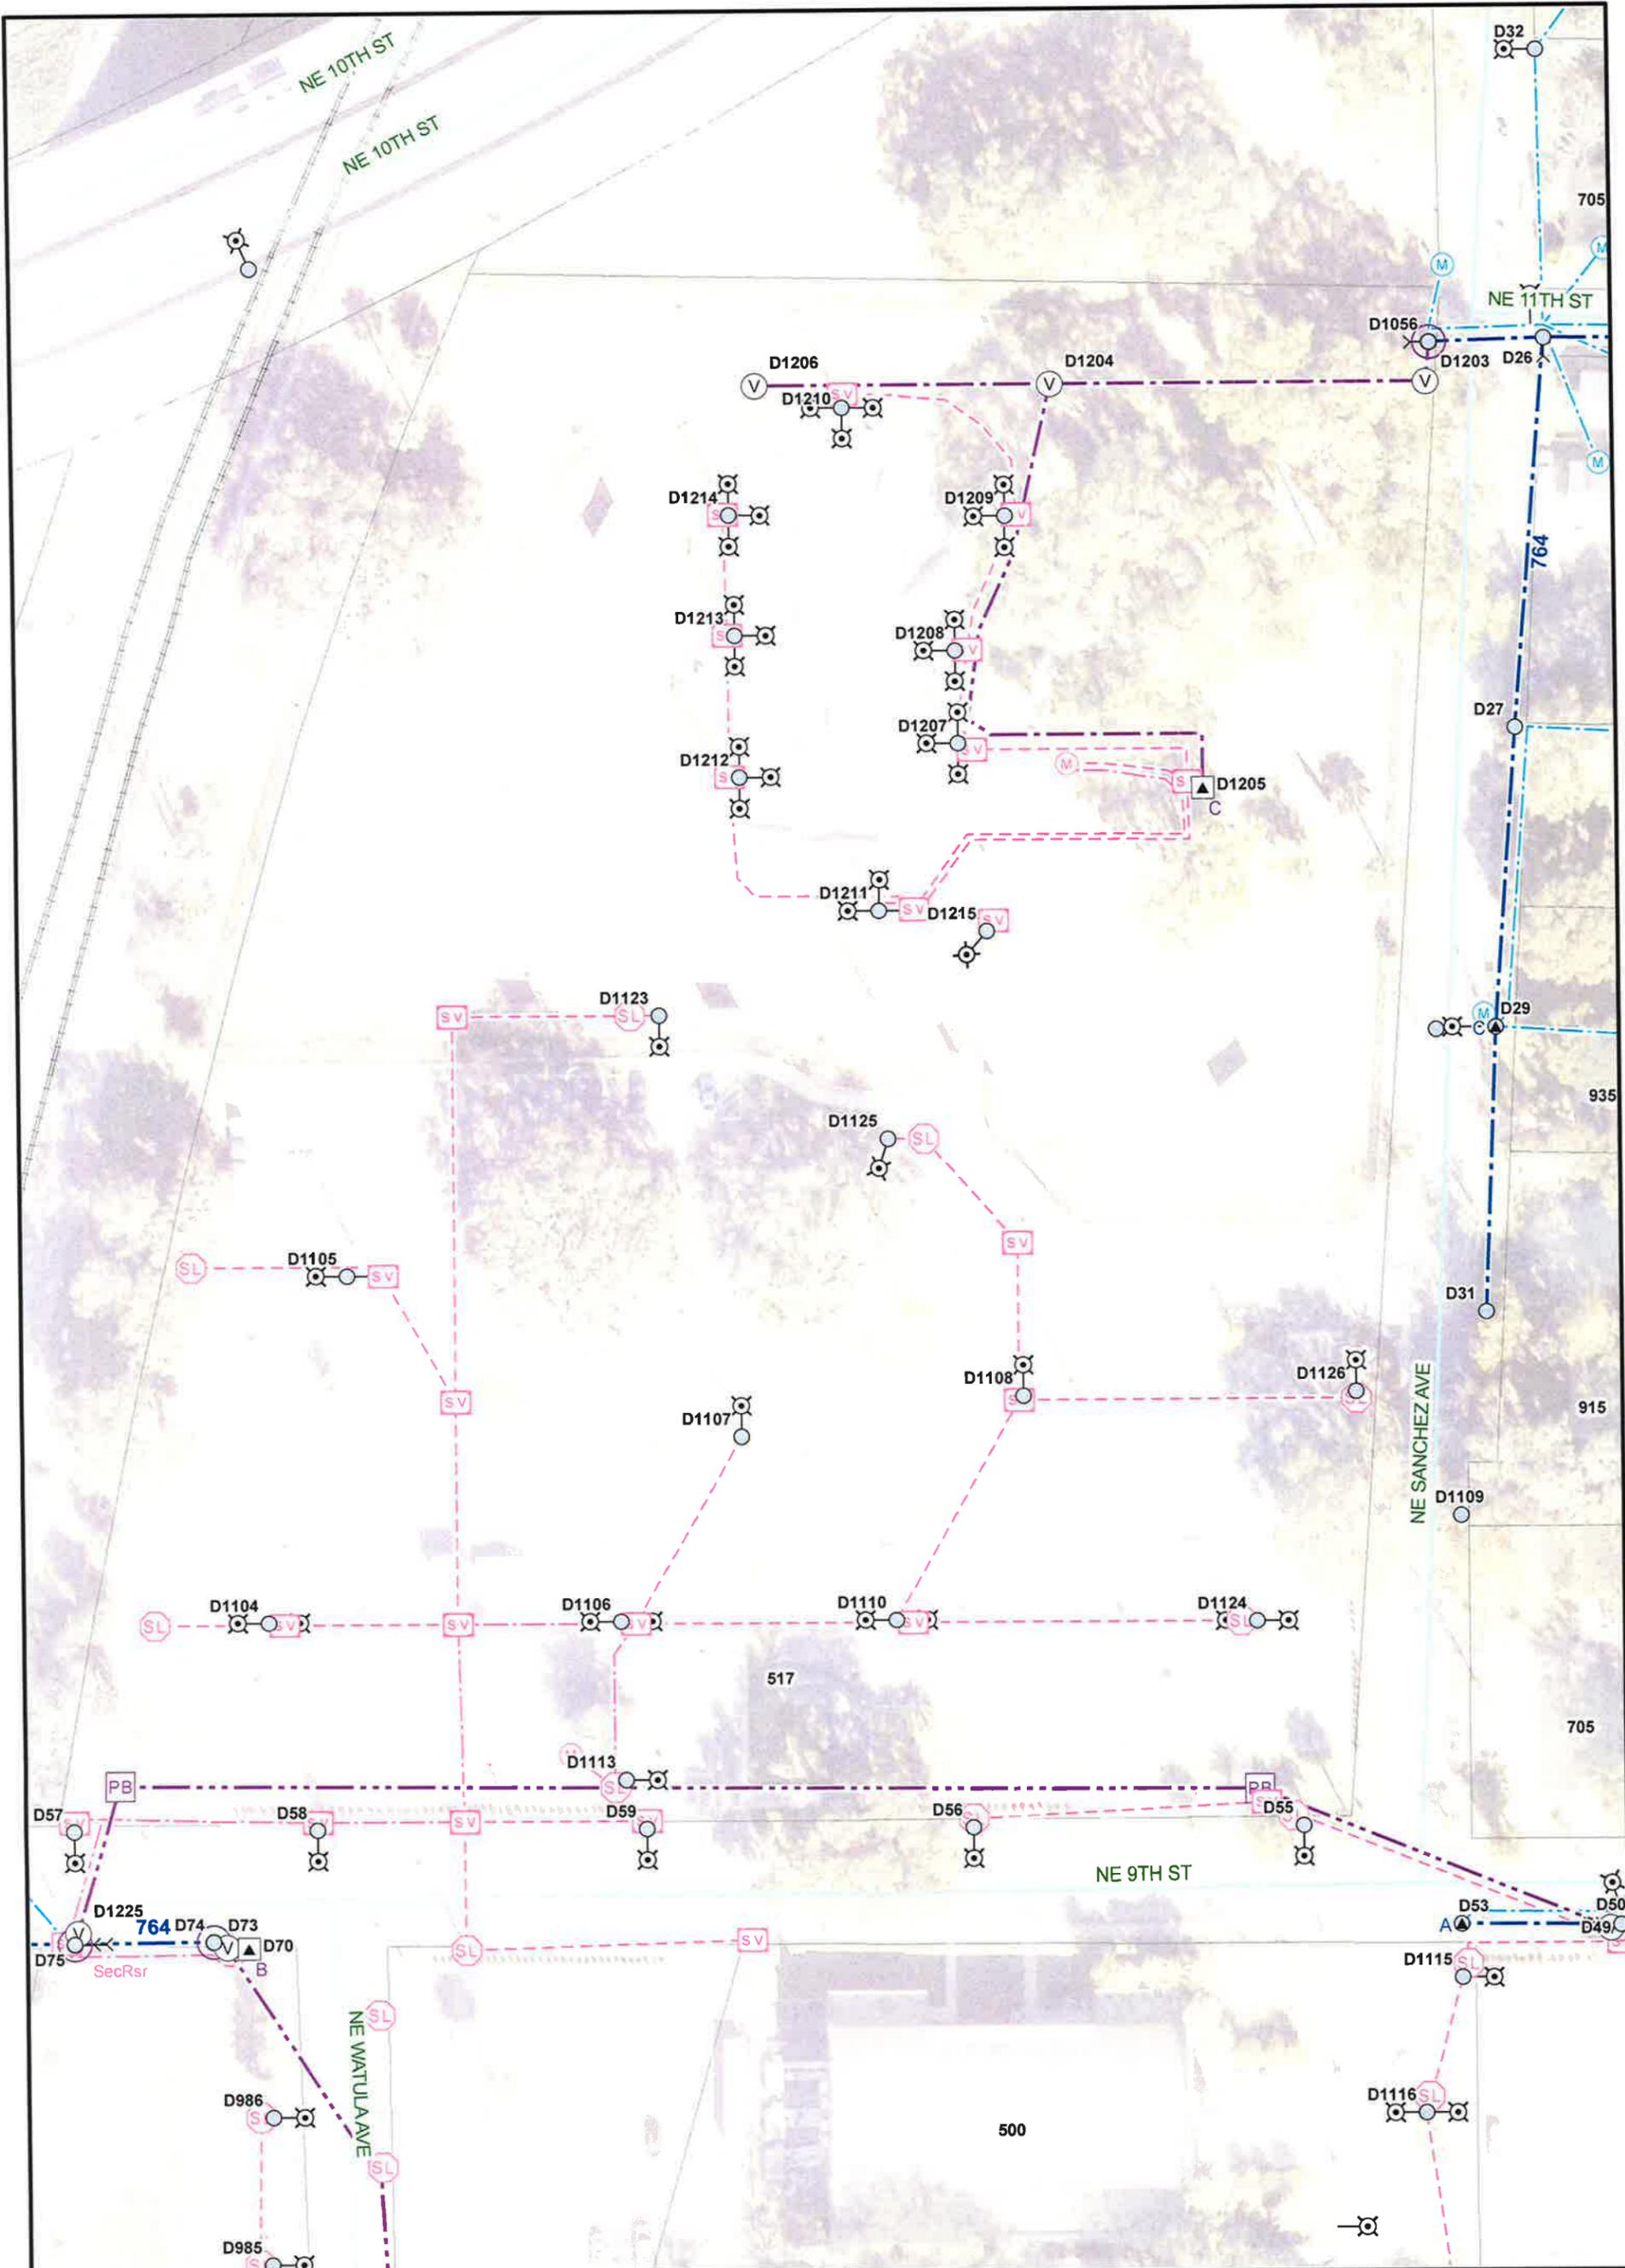

<p>AS BUILT</p> <p>SIGN</p> <p>DATE</p> <p>LOCATES: YES</p>	<p>1" = 60'</p>	<table border="1"> <tr> <th colspan="4" data-bbox="594 2735 1945 2781">Customer Name</th> </tr> <tr> <th colspan="4" data-bbox="594 2781 1945 2874">Design Description</th> </tr> <tr> <td data-bbox="594 2874 927 2937"> </td> <td data-bbox="927 2874 1128 2937"> 1805 NE 30 AVE Ocala, FL 34470 PH: (352) 351-6620 FX: (352) 401-6961 </td> <td data-bbox="1128 2874 1330 2937"> Prj #Project Number W#Order Number FO#: Field Order ID </td> <td data-bbox="1330 2874 1532 2937"> Ckt: First Feeder ID Eng: JConstable Date: 3/14/2024 </td> <td data-bbox="1532 2874 1945 2937"> Location Address </td> </tr> </table>				Customer Name				Design Description					1805 NE 30 AVE Ocala, FL 34470 PH: (352) 351-6620 FX: (352) 401-6961	Prj #Project Number W#Order Number FO#: Field Order ID	Ckt: First Feeder ID Eng: JConstable Date: 3/14/2024	Location Address
Customer Name																		
Design Description																		
	1805 NE 30 AVE Ocala, FL 34470 PH: (352) 351-6620 FX: (352) 401-6961	Prj #Project Number W#Order Number FO#: Field Order ID	Ckt: First Feeder ID Eng: JConstable Date: 3/14/2024	Location Address														